

File No.: 04-1000-20-2020-283

June 23, 2020

s.22(1)

Dear s.22(1)

Re: **Request for Access to Records under the Freedom of Information and Protection of Privacy Act (the "Act")**

I am responding to your request of April 24, 2020 for records regarding:

Lane closure(s) due to construction at West Georgia and Burrard, on February 4, 2020 at 9:30 am.

All responsive records are attached.

Under section 52 of the Act you may ask the Information & Privacy Commissioner to review any matter related to the City's response to your request. The Act allows you 30 business days from the date you receive this notice to request a review by writing to: Office of the Information & Privacy Commissioner, info@oipc.bc.ca or by phoning 250-387-5629.

If you request a review, please provide the Commissioner's office with: 1) the request number assigned to your request (#04-1000-20-2020-283); 2) a copy of this letter; 3) a copy of your original request for information sent to the City of Vancouver; and 4) detailed reasons or grounds on which you are seeking the review.

Please do not hesitate to contact the Freedom of Information Office at foi@vancouver.ca if you have any questions.

Yours truly,

[Signature on file]

Barbara J. Van Fraassen, BA
Director, Access to Information & Privacy

Barbara.vanfraassen@vancouver.ca
453 W. 12th Avenue Vancouver BC V5Y 1V4

*If you have any questions, please email us at foi@vancouver.ca and we will respond to you as soon as possible. Or you can call the FOI Case Manager at 604.871.6584.

Encl.

:kt

TRAFFIC CONTROL SYMBOLS

- FLEXIBLE TRAFFIC DRUMS

CLASS 1 BARRICADES

VANCOUVER POLICE PERSONNEL

TRAFFIC CONTROL PERSONNEL

CONCRETE ROADSIDE BARRIER

TRAFFIC SIGNAGE
- TYPE-D TUBULAR MARKER


WEEKDAY WORK ZONE

WEEKEND WORK ZONE

LANE CLOSURE AREA

OPPOSING TRAFFIC LANE DIVIDERS

CHANGEABLE MESSAGE SIGN

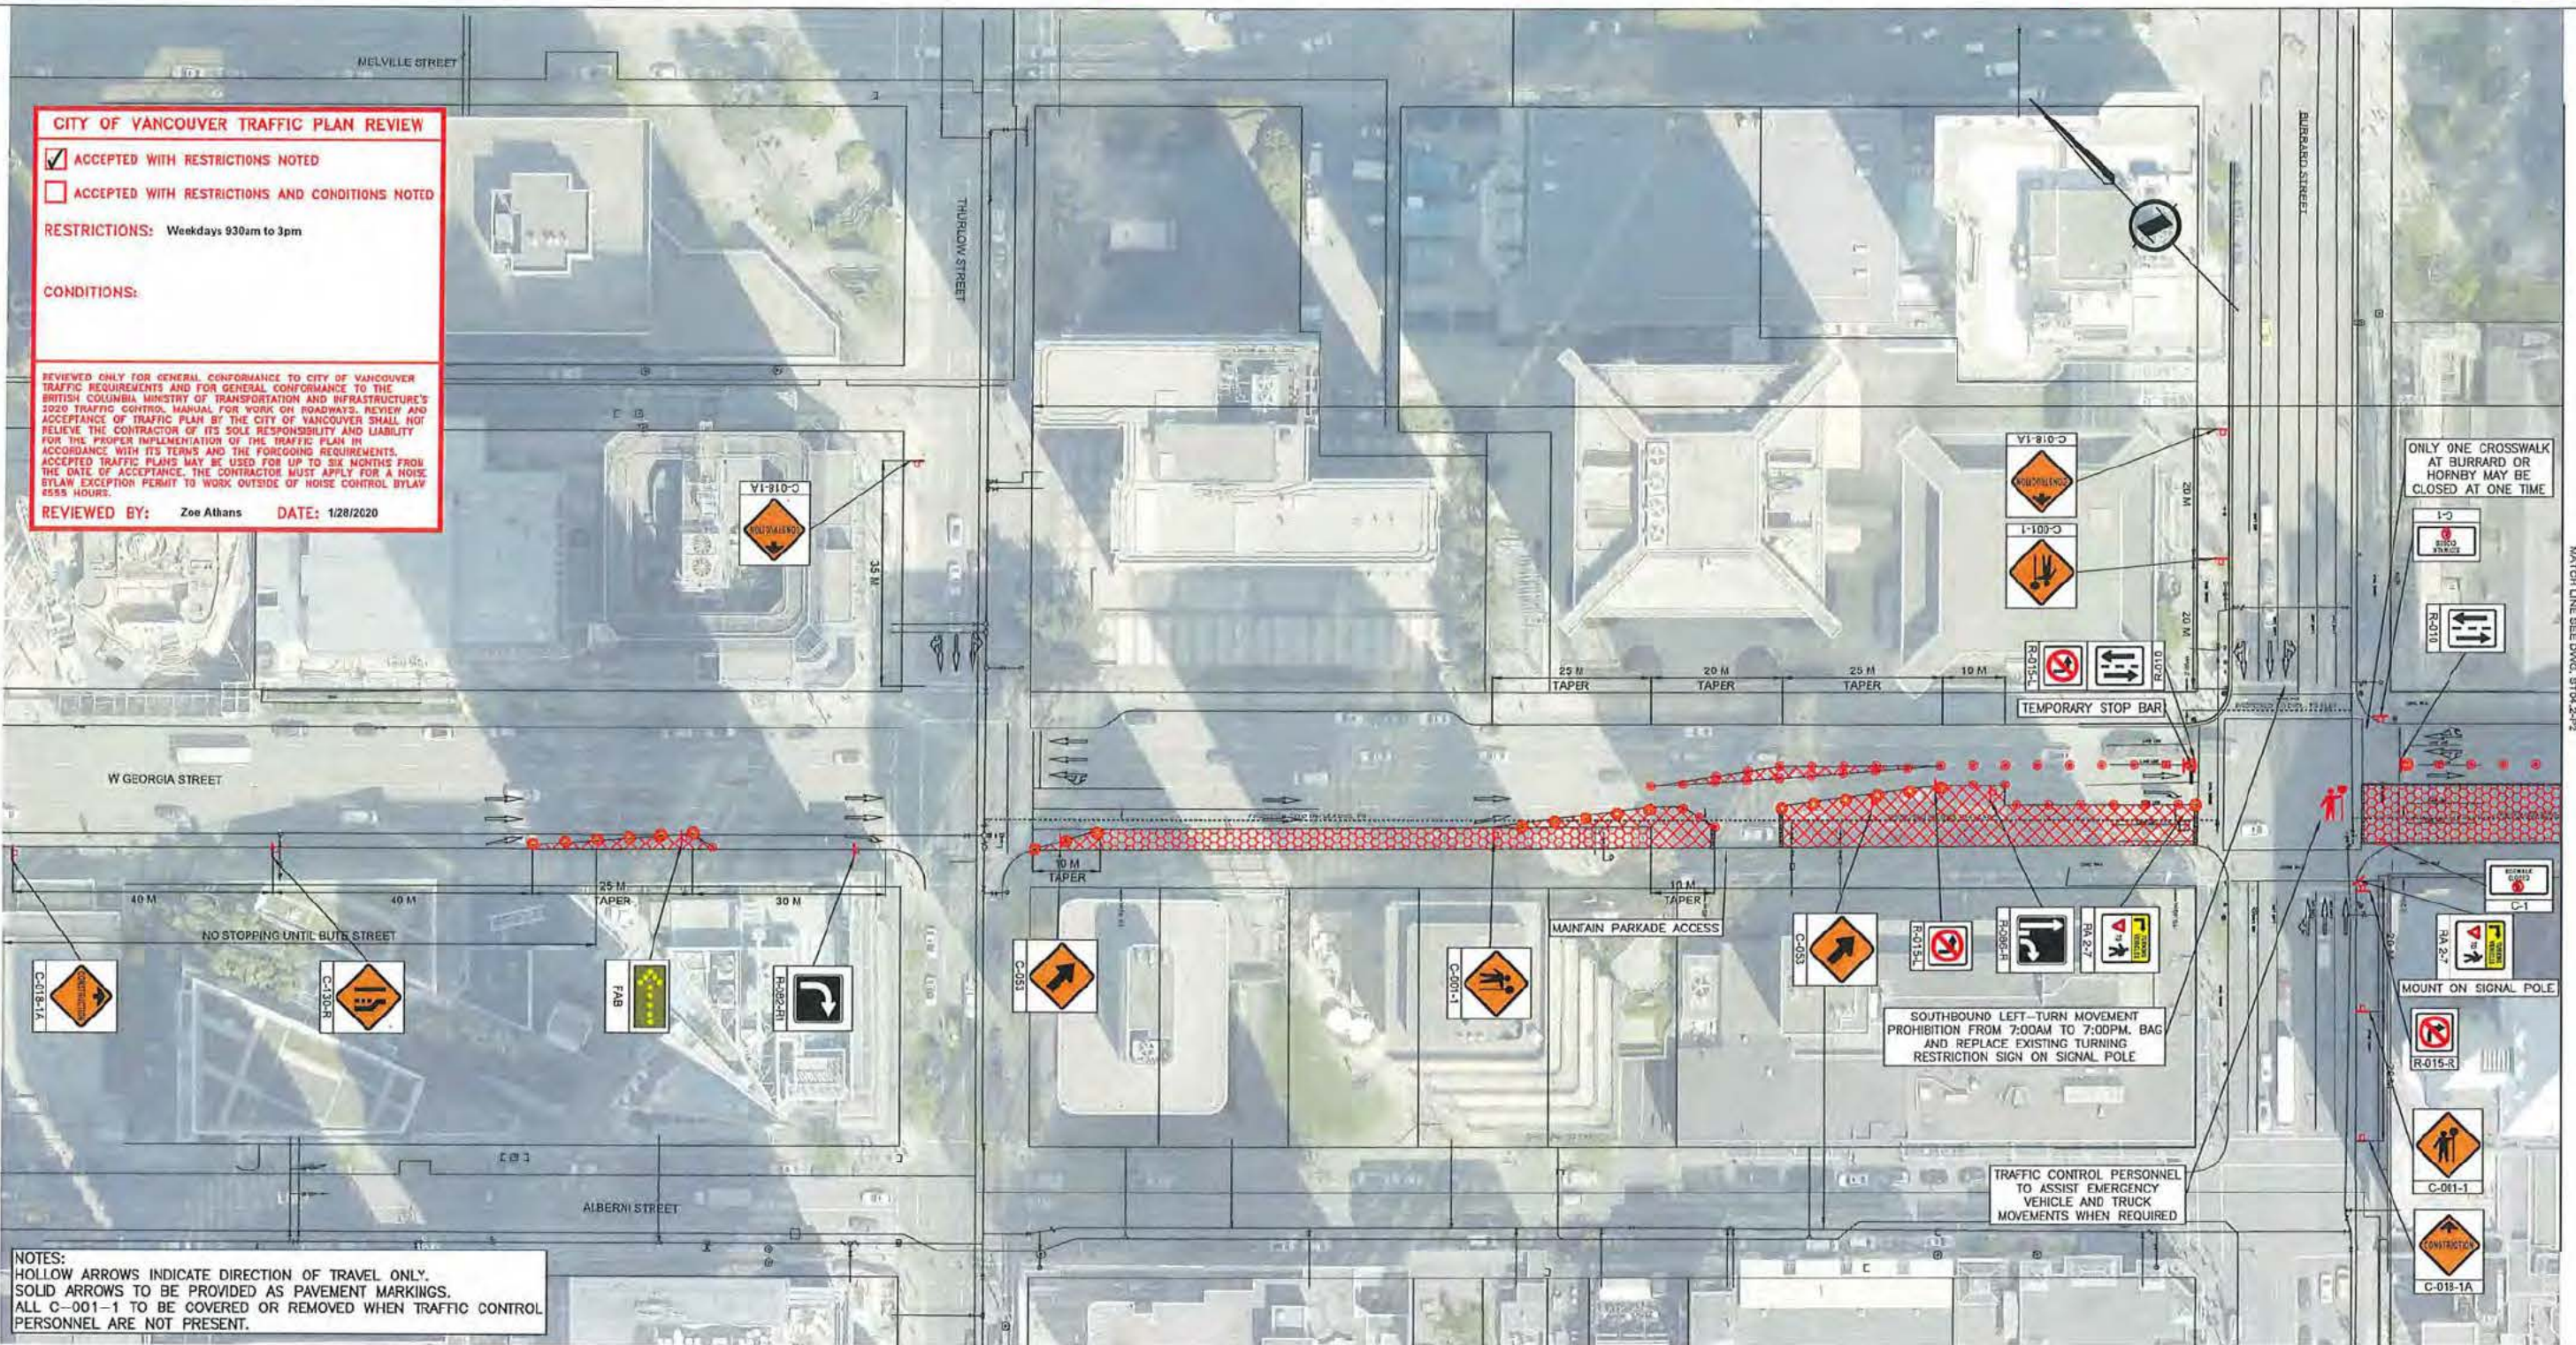

NOTES:
HOLLOW ARROWS INDICATE DIRECTION OF TRAVEL ONLY.
SOLID ARROWS TO BE PROVIDED AS PAVEMENT MARKINGS.
ALL C-001-1 TO BE COVERED OR REMOVED WHEN TRAFFIC CONTROL PERSONNEL ARE NOT PRESENT.


FOR IMPLEMENTATION

GENERAL TRAFFIC MANAGEMENT REQUIREMENTS:

MAXIMUM DISTANCE BETWEEN TUBULAR MARKER	5m
MAXIMUM DISTANCE BETWEEN BARRELS	5m
MINIMUM LANE WIDTH	3m
EXISTING POSTED SPEED	50km/h
DESIGN VEHICLE	WB-17



R.F. BINNIE & ASSOCIATES LTD.
300-4940 Canada Way
Burnaby, BC V5G 4K6
TEL 604 420 1721
BINNIE.COM

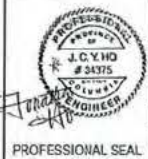

REV	DATE	REVISIONS	SIGNATURE


SCALE 0 5 1:500 25m
CAD FILE NAME: 19-1196-W GEORGIA WATERMAIN TWP.DWG
DATE: 2020-01-23
SENIOR DESIGNER: [Signature]
DATE: 2020-01-23

DESIGNED	ALL	DATE	2020-01-23
QUALITY CONTROL	ALL	DATE	2020-01-23
QUALITY ASSURANCE	JND	DATE	2020-01-23
DRAWN	MVS	DATE	2020-01-23

TRAFFIC CONTROL PLAN W. GEORGIA WATERMAIN REPLACEMENT PROJECT				
STAGE 4.1 - BURRARD TO HOWE - 3 LANE CLOSURE				
FILE NUMBER	PROJECT NUMBER	SFR	DRAWING NUMBER	REV
19-1196-00	19-1196	1	ST04.2-P1	0

TRAFFIC CONTROL SYMBOLS

FLEXIBLE TRAFFIC DRUMS CLASS 1 BARRICADES VANCOUVER POLICE PERSONNEL TRAFFIC CONTROL PERSONNEL CONCRETE ROADSIDE BARRIER TRAFFIC SIGNAGE
TYPE-D TUBULAR MARKER WEEKDAY WORK ZONE WEEKEND WORK ZONE LANE CLOSURE AREA OPPOSING TRAFFIC LANE DIVIDERS CHANGEABLE MESSAGE SIGN

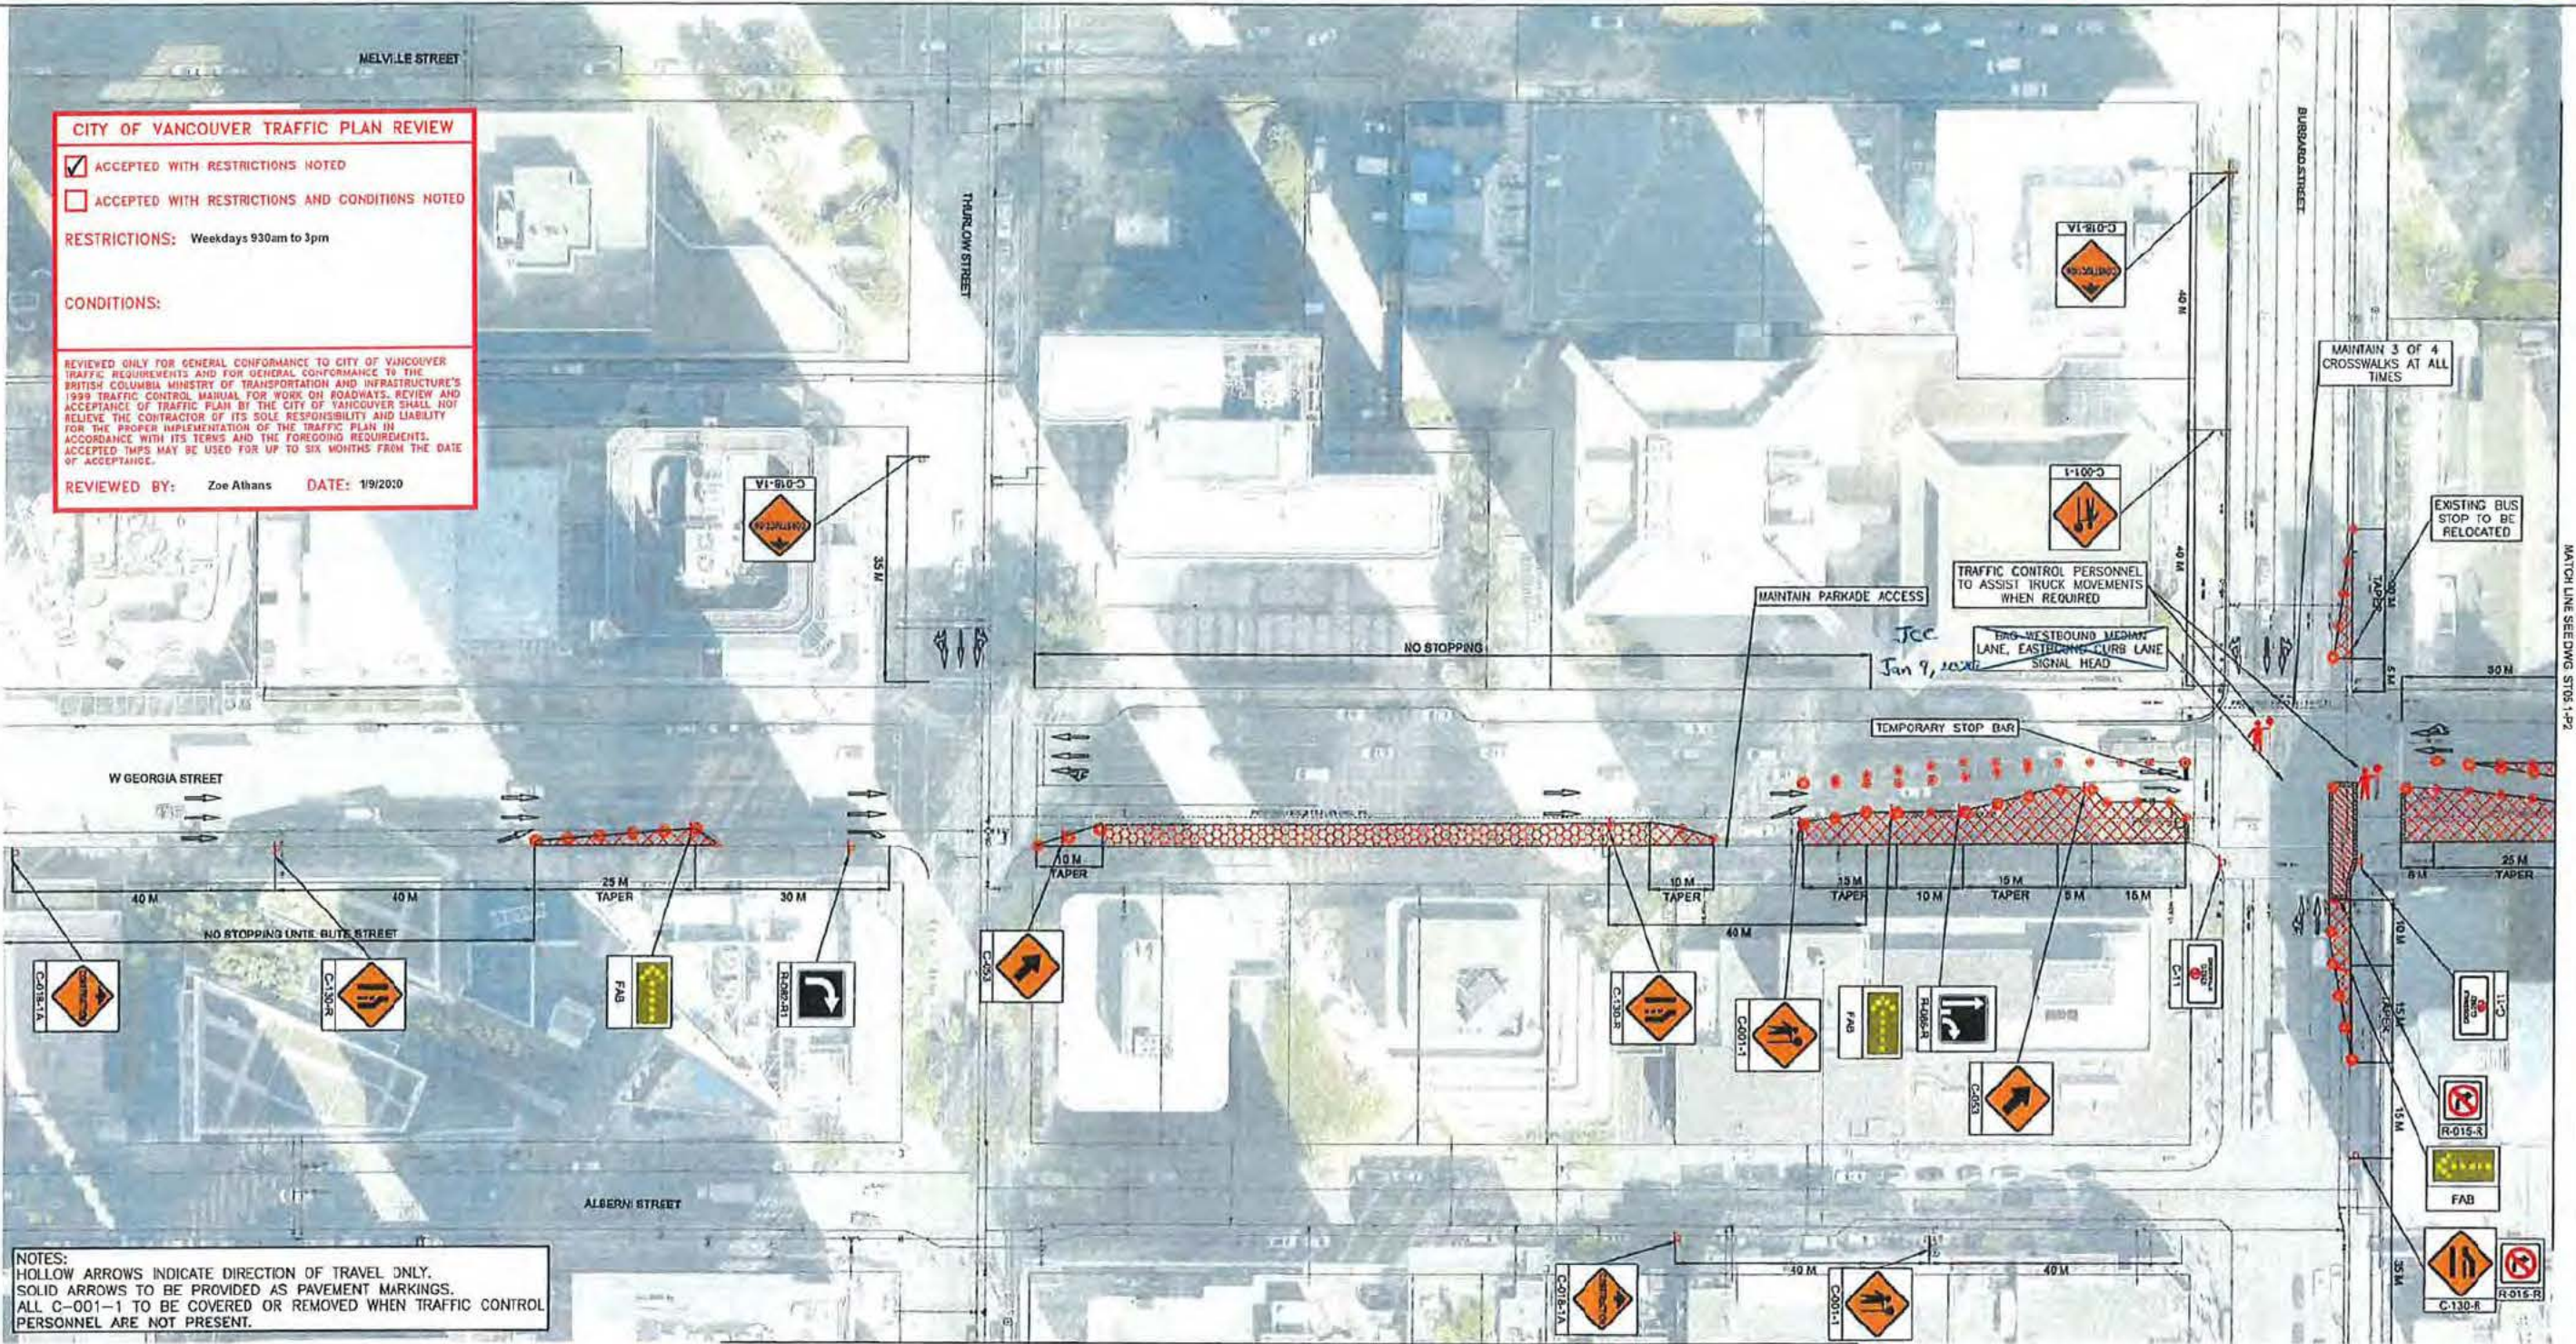

CITY OF VANCOUVER TRAFFIC PLAN REVIEW

☒ ACCEPTED WITH RESTRICTIONS NOTED
☐ ACCEPTED WITH RESTRICTIONS AND CONDITIONS NOTED

RESTRICTIONS: Weekdays 930am to 3pm

CONDITIONS:

REVIEWED ONLY FOR GENERAL CONFORMANCE TO CITY OF VANCOUVER TRAFFIC REQUIREMENTS AND FOR GENERAL CONFORMANCE TO THE BRITISH COLUMBIA MINISTRY OF TRANSPORTATION AND INFRASTRUCTURE'S 1999 TRAFFIC CONTROL MANUAL FOR WORK ON ROADWAYS. REVIEW AND ACCEPTANCE OF TRAFFIC PLAN BY THE CITY OF VANCOUVER SHALL NOT RELIEVE THE CONTRACTOR OF ITS SOLE RESPONSIBILITY AND LIABILITY FOR THE PROPER IMPLEMENTATION OF THE TRAFFIC PLAN IN ACCORDANCE WITH ITS TERMS AND THE FOREGOING REQUIREMENTS. ACCEPTED TIPS MAY BE USED FOR UP TO SIX MONTHS FROM THE DATE OF ACCEPTANCE.

REVIEWED BY: Zoe Athans DATE: 1/9/2020

NOTES:
HOLLOW ARROWS INDICATE DIRECTION OF TRAVEL ONLY.
SOLID ARROWS TO BE PROVIDED AS PAVEMENT MARKINGS.
ALL C-001-1 TO BE COVERED OR REMOVED WHEN TRAFFIC CONTROL PERSONNEL ARE NOT PRESENT.

FOR IMPLEMENTATION

GENERAL TRAFFIC MANAGEMENT REQUIREMENTS:

MAXIMUM DISTANCE BETWEEN TUBULAR MARKER	5m
MAXIMUM DISTANCE BETWEEN BARRELS	5m
MINIMUM LANE WIDTH	3m
EXISTING POSTED SPEED	50km/h
DESIGN VEHICLE	WB-17

BINNIE
The people behind your infrastructure.

B.F. BINNIE & ASSOCIATES LTD.
100 - 4140 Canada Way
Burnaby, BC V5G 4R5
TEL 604 430 3121
BINNIE.COM

PROFESSIONAL SEAL

SCALE 0 5 1:500 25m

CAD FILE NAME: 11W W GEORGIA WATERMAIN TWP.DWG
DATE: 2020.01.03

REV	DATE	REVISIONS	SIGNATURE
0	2020-01-03	FOR IMPLEMENTATION	JHO

DATE: 2020-01-03

CITY OF VANCOUVER

DESIGNED: ALL DATE: 2020-01-03
QUALITY ASSURANCE: JHO DATE: 2020-01-03
DRAWING: MNOO DATE: 2020-01-03

SENIOR DESIGNER: [Signature]

TRAFFIC CONTROL PLAN
W. GEORGIA WATERMAIN REPLACEMENT PROJECT

BURRARD INTERSECTION - PRE-WORK

FILE NUMBER	PROJECT NUMBER	SPE	DRAWING NUMBER	REV
19-1196-00	19-1196	1	ST05.1-P1	0

TRAFFIC CONTROL SYMBOLS

FLEXIBLE TRAFFIC DRUMS

TYPE-D TUBULAR MARKER

CLASS 1 BARRICADES

WEEKDAY WORK ZONE

VANCOUVER POLICE PERSONNEL

WEEKEND WORK ZONE

TRAFFIC CONTROL PERSONNEL


LANE CLOSURE AREA

CONCRETE ROADSIDE BARRIER

OPPOSING TRAFFIC LANE DIVIDERS

TRAFFIC SIGNAGE

CHANGEABLE MESSAGE SIGN

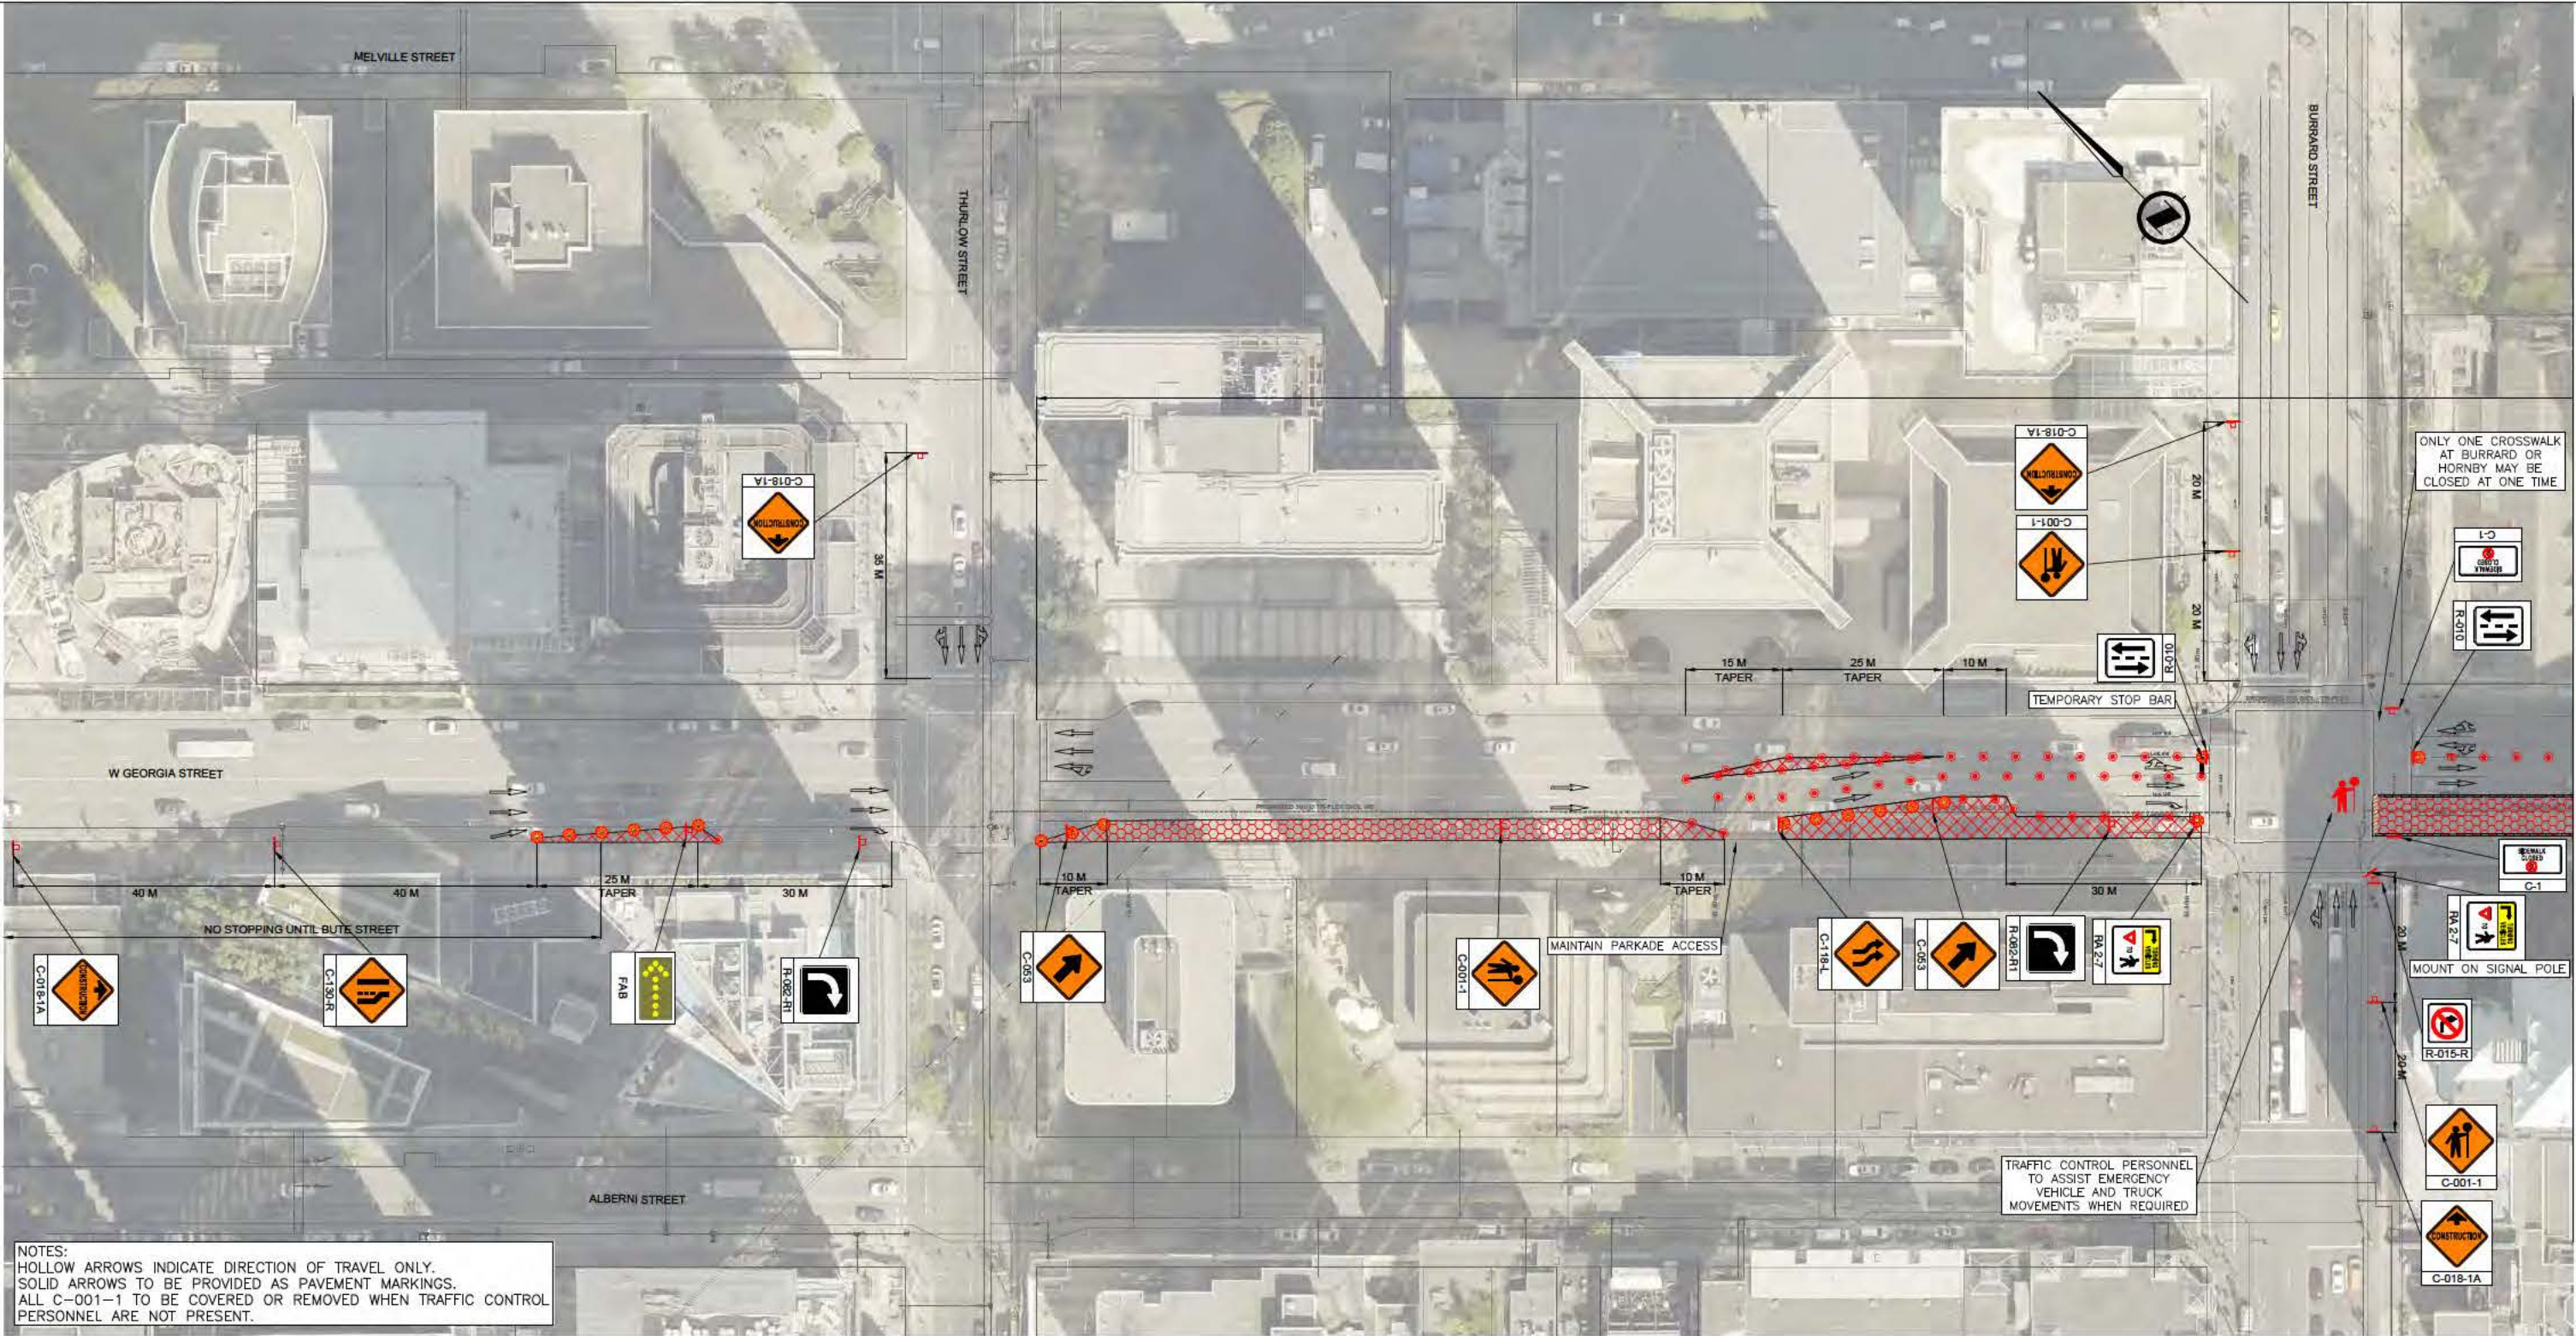

NOTES:
HOLLOW ARROWS INDICATE DIRECTION OF TRAVEL ONLY.
SOLID ARROWS TO BE PROVIDED AS PAVEMENT MARKINGS.
ALL C-001-1 TO BE COVERED OR REMOVED WHEN TRAFFIC CONTROL PERSONNEL ARE NOT PRESENT.

GENERAL TRAFFIC MANAGEMENT REQUIREMENTS:

MAXIMUM DISTANCE BETWEEN TUBULAR MARKER 5m
MAXIMUM DISTANCE BETWEEN BARRELS 5m
MINIMUM LANE WIDTH 3m
EXISTING POSTED SPEED 50km/h
DESIGN VEHICLE WB-17



R.P. BINNIE & ASSOCIATES LTD.
200-4040 Canada Way,
Burnaby, BC V5G 4H6
TEL: 604 430 3723
BINNIE.com



PROFESSIONAL SEAL

SCALE			CADD FILE NAME: 19-1196 W. GEORGIA WATERMAIN TMP.DWG	
0 5 1:500 25m			DATE 2020-01-23	
REV	DATE	REVISIONS	SIGNATURE	

SENIOR DESIGNER
DATE 2020-01-23



DESIGNED	ALL	DATE	2020-01-23
QUALITY CONTROL	ALL	DATE	2020-01-23
QUALITY ASSURANCE	JHD	DATE	2020-01-23
DRAWN	M.W.D.	DATE	2020-01-23

TRAFFIC CONTROL PLAN
W. GEORGIA WATERMAIN REPLACEMENT PROJECT

STAGE 4.1 - BURRARD TO HOWE - 2 LANE CLOSURE

FILE NUMBER	PROJECT NUMBER	SPR	DRAWING NUMBER	REV
19-1196-00	19-1196	1	ST04.1-P1	0

FLEXIBLE TRAFFIC DRUMS		CLASS 1 BARRICADES		VANCOUVER POLICE PERSONNEL		TRAFFIC CONTROL PERSONNEL		CONCRETE ROADSIDE BARRIER		TRAFFIC SIGNAGE	
TYPE-D TUBULAR MARKER		WEEKDAY WORK ZONE		WEEKEND WORK ZONE		LANE CLOSURE AREA		OPPOSING TRAFFIC LANE DIVIDERS		CHANGEABLE MESSAGE SIGN	



City of Vancouver - FOI 2020-283 - Page 4 of 6

TRAFFIC CONTROL SYMBOLS

FLEXIBLE TRAFFIC DRUMS

TYPE-D TUBULAR MARKER

CLASS 1 BARRICADES

WEEKDAY WORK ZONE

VANCOUVER POLICE PERSONNEL

WEEKEND WORK ZONE

TRAFFIC CONTROL PERSONNEL


LANE CLOSURE AREA

CONCRETE ROADSIDE BARRIER

OPPOSING TRAFFIC LANE DIVIDERS

TRAFFIC SIGNAGE

CHANGEABLE MESSAGE SIGN

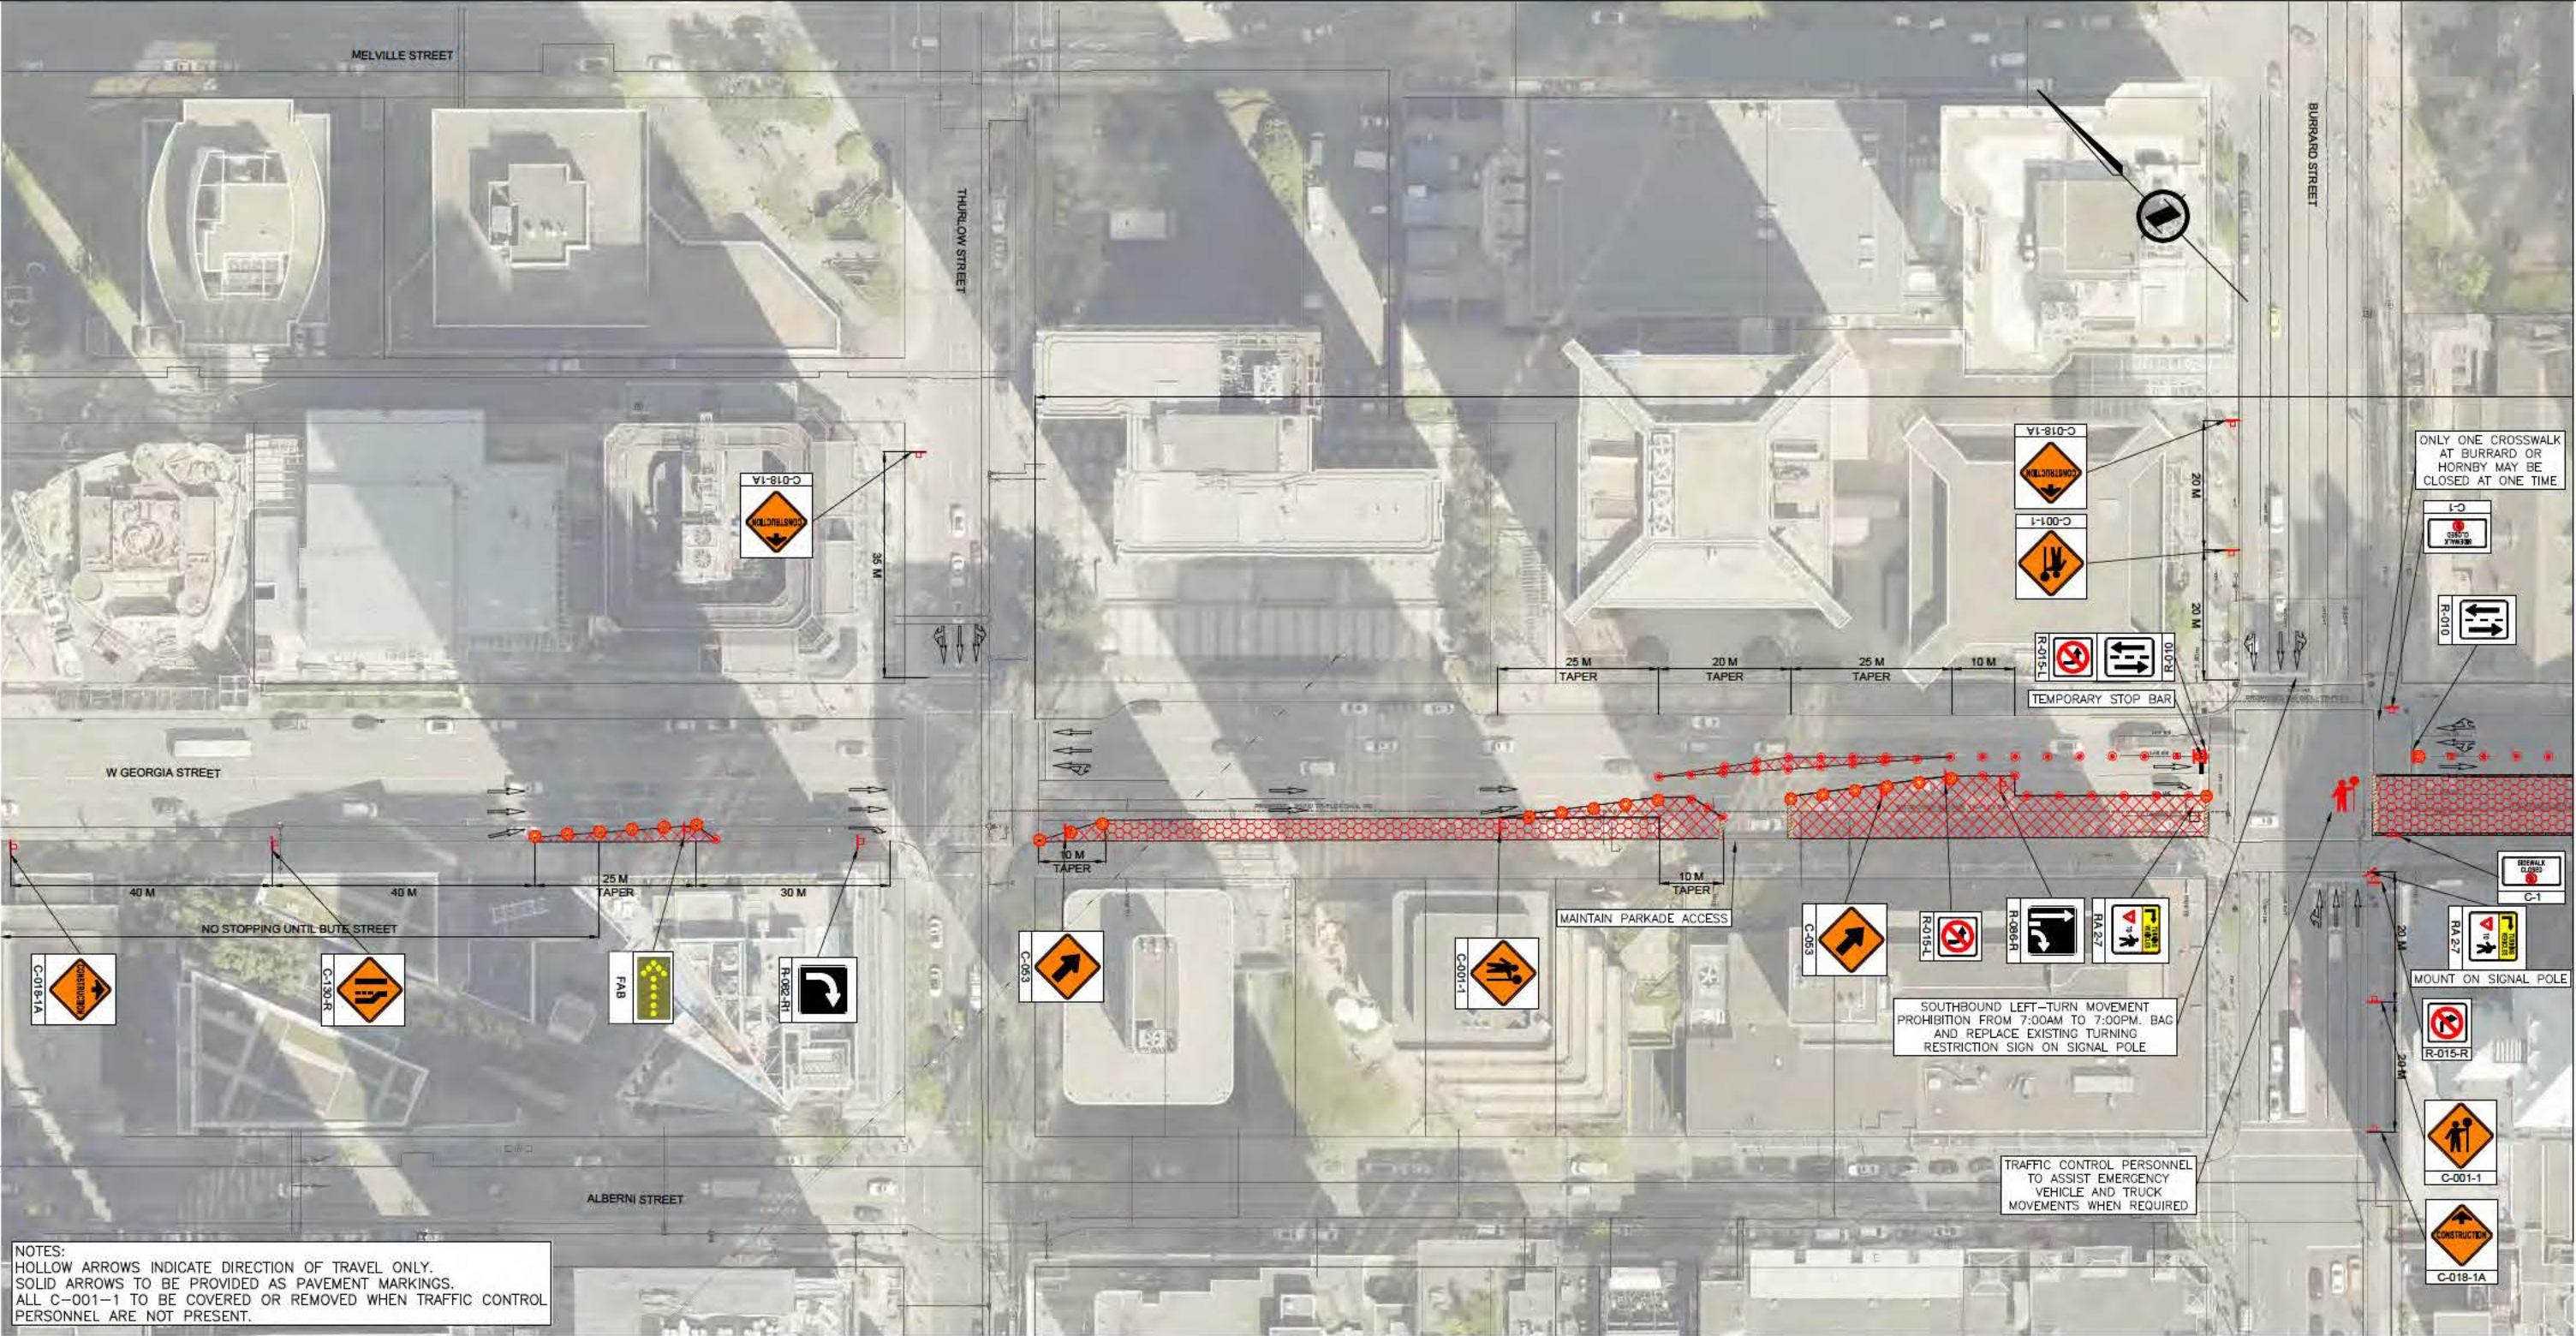

NOTES:
HOLLOW ARROWS INDICATE DIRECTION OF TRAVEL ONLY.
SOLID ARROWS TO BE PROVIDED AS PAVEMENT MARKINGS.
ALL C-001-1 TO BE COVERED OR REMOVED WHEN TRAFFIC CONTROL PERSONNEL ARE NOT PRESENT.

FOR IMPLEMENTATION

GENERAL TRAFFIC MANAGEMENT REQUIREMENTS:

MAXIMUM DISTANCE BETWEEN TUBULAR MARKER	5m
MAXIMUM DISTANCE BETWEEN BARRELS	5m
MINIMUM LANE WIDTH	3m
EXISTING POSTED SPEED	50km/h
DESIGN VEHICLE	WB-17

R.P. BINNIE & ASSOCIATES LTD.
200-4800 Canada Way,
Burnaby, BC V5G 4H6
TEL: 604 430 3723
BINNIE.com

PROFESSIONAL SEAL

REV	DATE	REVISIONS	SIGNATURE

SCALE 0 5 1:500 25m

CAD FILE NAME: 19-1196 W. GEORGIA WATERMAIN TMP.DWG

DATE 2020-01-23

DESIGNED: ALJ DATE 2020-01-23

QUALITY CONTROL: ALJ DATE 2020-01-23

QUALITY ASSURANCE: JHD DATE 2020-01-23

DRAWN: M.W.D. DATE 2020-01-23

SENIOR DESIGNER: [Signature] DATE 2020-01-23

CITY OF VANCOUVER

TRAFFIC CONTROL PLAN
W. GEORGIA WATERMAIN REPLACEMENT PROJECT

STAGE 4.1 - BURRARD TO HOWE - 3 LANE CLOSURE

FILE NUMBER	PROJECT NUMBER	SPR	DRAWING NUMBER	REV
19-1196-00	19-1196	1	ST04.2-P1	0

FLEXIBLE TRAFFIC DRUMS		CLASS 1 BARRICADES		VANCOUVER POLICE PERSONNEL		TRAFFIC CONTROL PERSONNEL		CONCRETE ROADSIDE BARRIER		TRAFFIC SIGNAGE	
TYPE-D TUBULAR MARKER		WEEKDAY WORK ZONE		WEEKEND WORK ZONE		LANE CLOSURE AREA		OPPOSING TRAFFIC LANE DIVIDERS		CHANGEABLE MESSAGE SIGN	



City of Vancouver - FOI 2020-283 - Page 6 of 6