

File No.: 2026-091

February 17, 2026

s.22(1)

Dear s.22(1)

Re: **Request for Access to Records under the Freedom of Information and Protection of Privacy Act (the "Act")**

I am responding to your request of January 26, 2026 under the *Freedom of Information and Protection of Privacy Act* for:

1. **Record of invert depths of manholes located at the corner of Denman Street and Nelson Street, adjacent to 1015 Denman Street; and**
2. **Records (e.g. engineering drawings) related to the sanitary and storm sewers along the section of Denman Street between Nelson Street and Henshaw Lane. Date range: January 1, 1928 to December 31, 1974.**

All responsive records are attached. Please also note that this and similar information is publicly available on the City of Vancouver's website. You can find it using the publicly available VanMap application at this link: <https://maps.vancouver.ca/infrastructure/>.

- Please visit the following link for assistance using VanMap: <https://maps.vancouver.ca/portal/apps/sites/#/vanmap/pages/how-to>
- Additional information can be found on the City's Open Data Portal at the following locations:
  - [https://opendata.vancouver.ca/explore/dataset/sewer-mains/information/?disjunctive.effluent\\_type&disjunctive.material](https://opendata.vancouver.ca/explore/dataset/sewer-mains/information/?disjunctive.effluent_type&disjunctive.material)
  - <https://opendata.vancouver.ca/explore/dataset/sewer-manholes/information/?disjunctive.type>

Under Part 5 of the Act, you may ask the Information & Privacy Commissioner to review any matter related to the City's response to your FOI request by writing to: Office of the Information & Privacy Commissioner, [info@oipc.bc.ca](mailto:info@oipc.bc.ca) or by phoning 250-387-5629.

If you request a review, please provide the Commissioner's office with: 1) the request number (2026-091); 2) a copy of this letter; 3) a copy of your original request; and 4) detailed reasons why you are seeking the review.

Yours truly,

Kevin Tuerlings, FOI Case Manager, for

*[Signed by Kevin Tuerlings]*


**Siân Madsen, MA, MAS**  
**Acting Director, Access to Information & Privacy**

If you have any questions, please email us at [foi@vancouver.ca](mailto:foi@vancouver.ca) and we will respond to you as soon as possible. You may also contact 3-1-1 (604-873-7000) if you require accommodation or do not have access to email.

Encl. (Response package)

:pm


# Staff VanMap Viewer

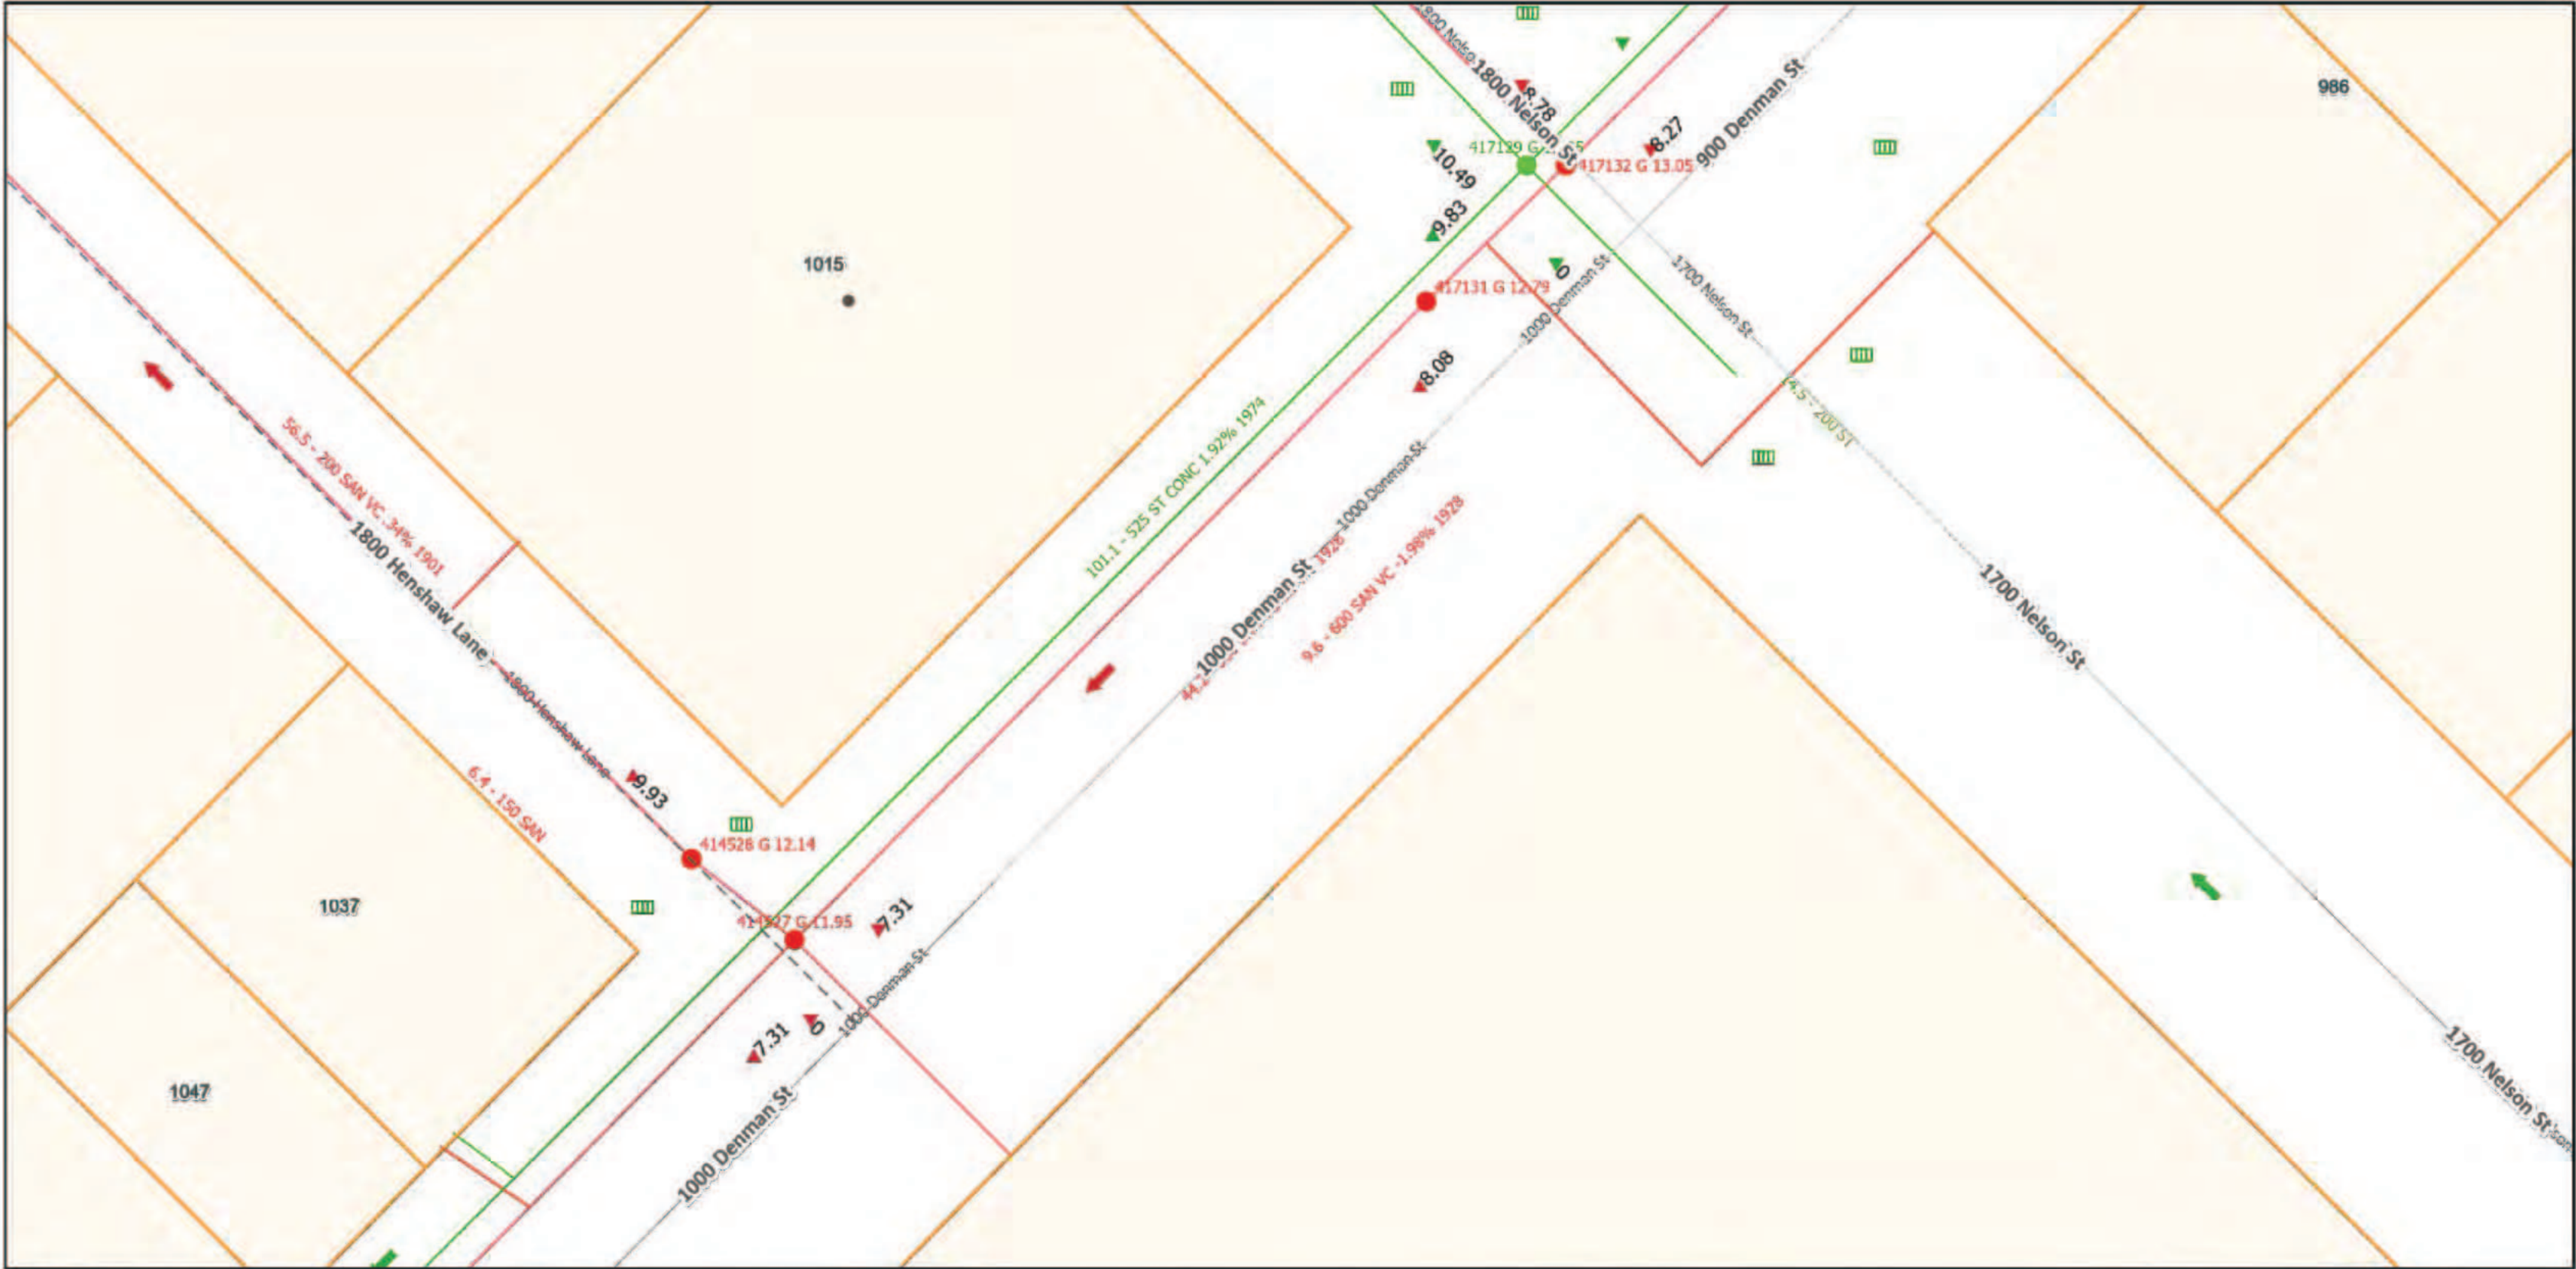

1/29/2026, 2:15:41 PM

Scale: 1:436

- |                          |                         |                          |                                   |                          |                                |
|--------------------------|-------------------------|--------------------------|-----------------------------------|--------------------------|--------------------------------|
| Local Area Labels        | Street Names (Dark)     | Storm Mains              | Manhole Elevation Labels          | Downstream Invert Symbol | Downstream Invert Label        |
| Property Parcels         | Addressable Lane (Dark) | Sanitary Main            | Manhole Comment Labels            | Sanitary                 | Upstream Invert Label          |
| Property Address Numbers | Service Lines           | Gravity or not indicated | Sewer Main Directional Flow Arrow | Storm                    | Sewer Main Labels              |
| Street Centerlines       | Sanitary                | Sewer Manholes           | Sanitary                          | Sanitary                 | Storm Catch Basin (In Service) |
| Addressable Lane         | Storm                   | Sanitary                 | Storm                             | Storm                    |                                |

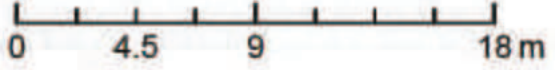

E T  
607/109

110/606

606/109

